

TRAFFIC REGULATION ORDER (TRO) CONSULTATION

WOR8029MM – Worthing: Various Roads Minor Amendments

19/9/24 – 10/10/24

Contents

Notice	Page 2
Statement of Reasons	Page 3
Draft Order	Page 4
Plans – Existing & Proposed	Pages 5-20

West Sussex County Council
((Worthing) (Parking Places & Traffic Regulation) (Consolidation) Order 2007)

(Various Roads Minor Amendment) Order 2024

NOTICE is hereby given that West Sussex County Council proposes to make a permanent Traffic regulation Order under the provisions of the Road Traffic Regulation Act 1984, the effect of which will be to make minor alterations to parking restrictions in Worthing as follows:

To introduce a short length of double yellow line on the northern side of Grafton Place at the entrance to a property;
To enact an existing bay for disabled person's blue badge holders on the southern side of Orme Road;
To enact an existing loading bay on the south side of Brighton Road outside the Splash Point Development
To make a short extension of existing double yellow lines on the southwestern bend in Devonport Road.

Full details of the proposals in this notice can be viewed on the Traffic Regulation Order page of the [West Sussex County Council website](https://www.westsussex.gov.uk/traffic-regulation-order). The website includes a response form for any comments or objections.

People without access to a computer who wish to view details of the scheme should telephone the West Sussex County Council Contact Centre on 01243 642105 to receive the documents by post.

Any comments or objections about the proposal must be received before 10 October 2024. These may be submitted via the response form on the website mentioned above, by e-mail to tro.consultation@westsussex.gov.uk or in writing to TRO Team, West Sussex County Council, The Grange, Tower Street, Chichester, PO19 1RH. For legal reasons, only correspondence including a full name and address will be considered. Please quote reference WOR8029-MM in all correspondence.

Dated this 19th day of September 2024.
Director of Law & Assurance, County Hall, Chichester.

West Sussex County Council
((Worthing) (Parking Places & Traffic Regulation) (Consolidation) Order 2007)

(Various Roads Minor Amendment) Order 2024

Statement of Reasons for Proposing to Make the Order

West Sussex County Council proposes to make a permanent Traffic Regulation Order that will make minor alterations to parking restrictions in Worthing as follows:

To introduce a short length of double yellow line on the northern side of Grafton Place at the entrance to a property. There is presently a parking bay at this location and with no footway on the road, parked vehicles often obstruct access to the front door of an adjacent property. A short length of double yellow line proposed to address this issue.

To enact an existing bay for disabled person's blue badge holders on the southern side of Orme Road. The parking bay at this location was installed previously and the Order is being amended to make it legally enforceable if needed.

To enact an existing loading bay on the south side of Brighton Road outside the Splash Point Development. This bay was advertised and installed when the development was constructed, but the legal order enacting it was not completed because the restriction on the bay was incorrectly signed. This order makes the existing bay enforceable.

To make a short extension of existing double yellow lines on the southwestern bend in Devonport Road. This is a short adjustment to the length of lines to improve visibility on the bend.

The new order is therefore proposed to preserve or improve the amenities of the area through which the roads run and to facilitate the passage of traffic.

The attached drawings, numbered TQ1402NES, TQ1403SWN, TQ1502NES and TQ1602NWN show the lengths of roads affected by the proposed order.

Director of Law & Assurance
11 September 2024
WOR8029-MM

WEST SUSSEX COUNTY COUNCIL
((WORTHING) (PARKING PLACES & TRAFFIC REGULATION) (CONSOLIDATION)
ORDER 2007)

(VARIOUS ROADS MINOR AMENDMENT) ORDER 2024

West Sussex County Council in exercise of their powers under Sections 1 (a) 2 (1) and (2), 4 (2), 45. 46. 49 and 53 and Part IV of Schedule 9 of the Road Traffic Regulation Act 1984 ("the Act") as amended and of all other enabling powers and after consultation with the Chief Officer of Police in accordance with Part III of Schedule 9 to the Act hereby make the following Order:-

1. The Order shall come into operation on the ***** day of ***** 2024 and may be cited as "West Sussex County Council) ((Worthing) (Parking Places & Traffic Regulation) (Consolidation) Order 2007) (Various Roads Minor Amendment) Order 2024".
2. The "West Sussex County Council ((Worthing) (Parking Places & Traffic Regulation) (Consolidation) Order 2007" is hereby amended by the replacement of the plans specified in the First Schedule to this Order, with the plans specified in the Second Schedule, attached hereto.

FIRST SCHEDULE
Plans to be Replaced

TQ1402NES (Issue Number 12)
TQ1403SWN (Issue Number 7)
TQ1502NES (Issue Number 7)
TQ1602NWN (Issue Number 5)

SECOND SCHEDULE
Replacement Plans

TQ1402NES (Issue Number 13)
TQ1403SWN (Issue Number 8)
TQ1502NES (Issue Number 8)
TQ1602NWN (Issue Number 6)

For and on behalf of WEST SUSSEX COUNTY COUNCIL


Authorised Signatory:

NAME:


DATE MADE:


WOR8029-MM

PAGE 1 OF 2: EXISTING RESTRICTIONS ONLY

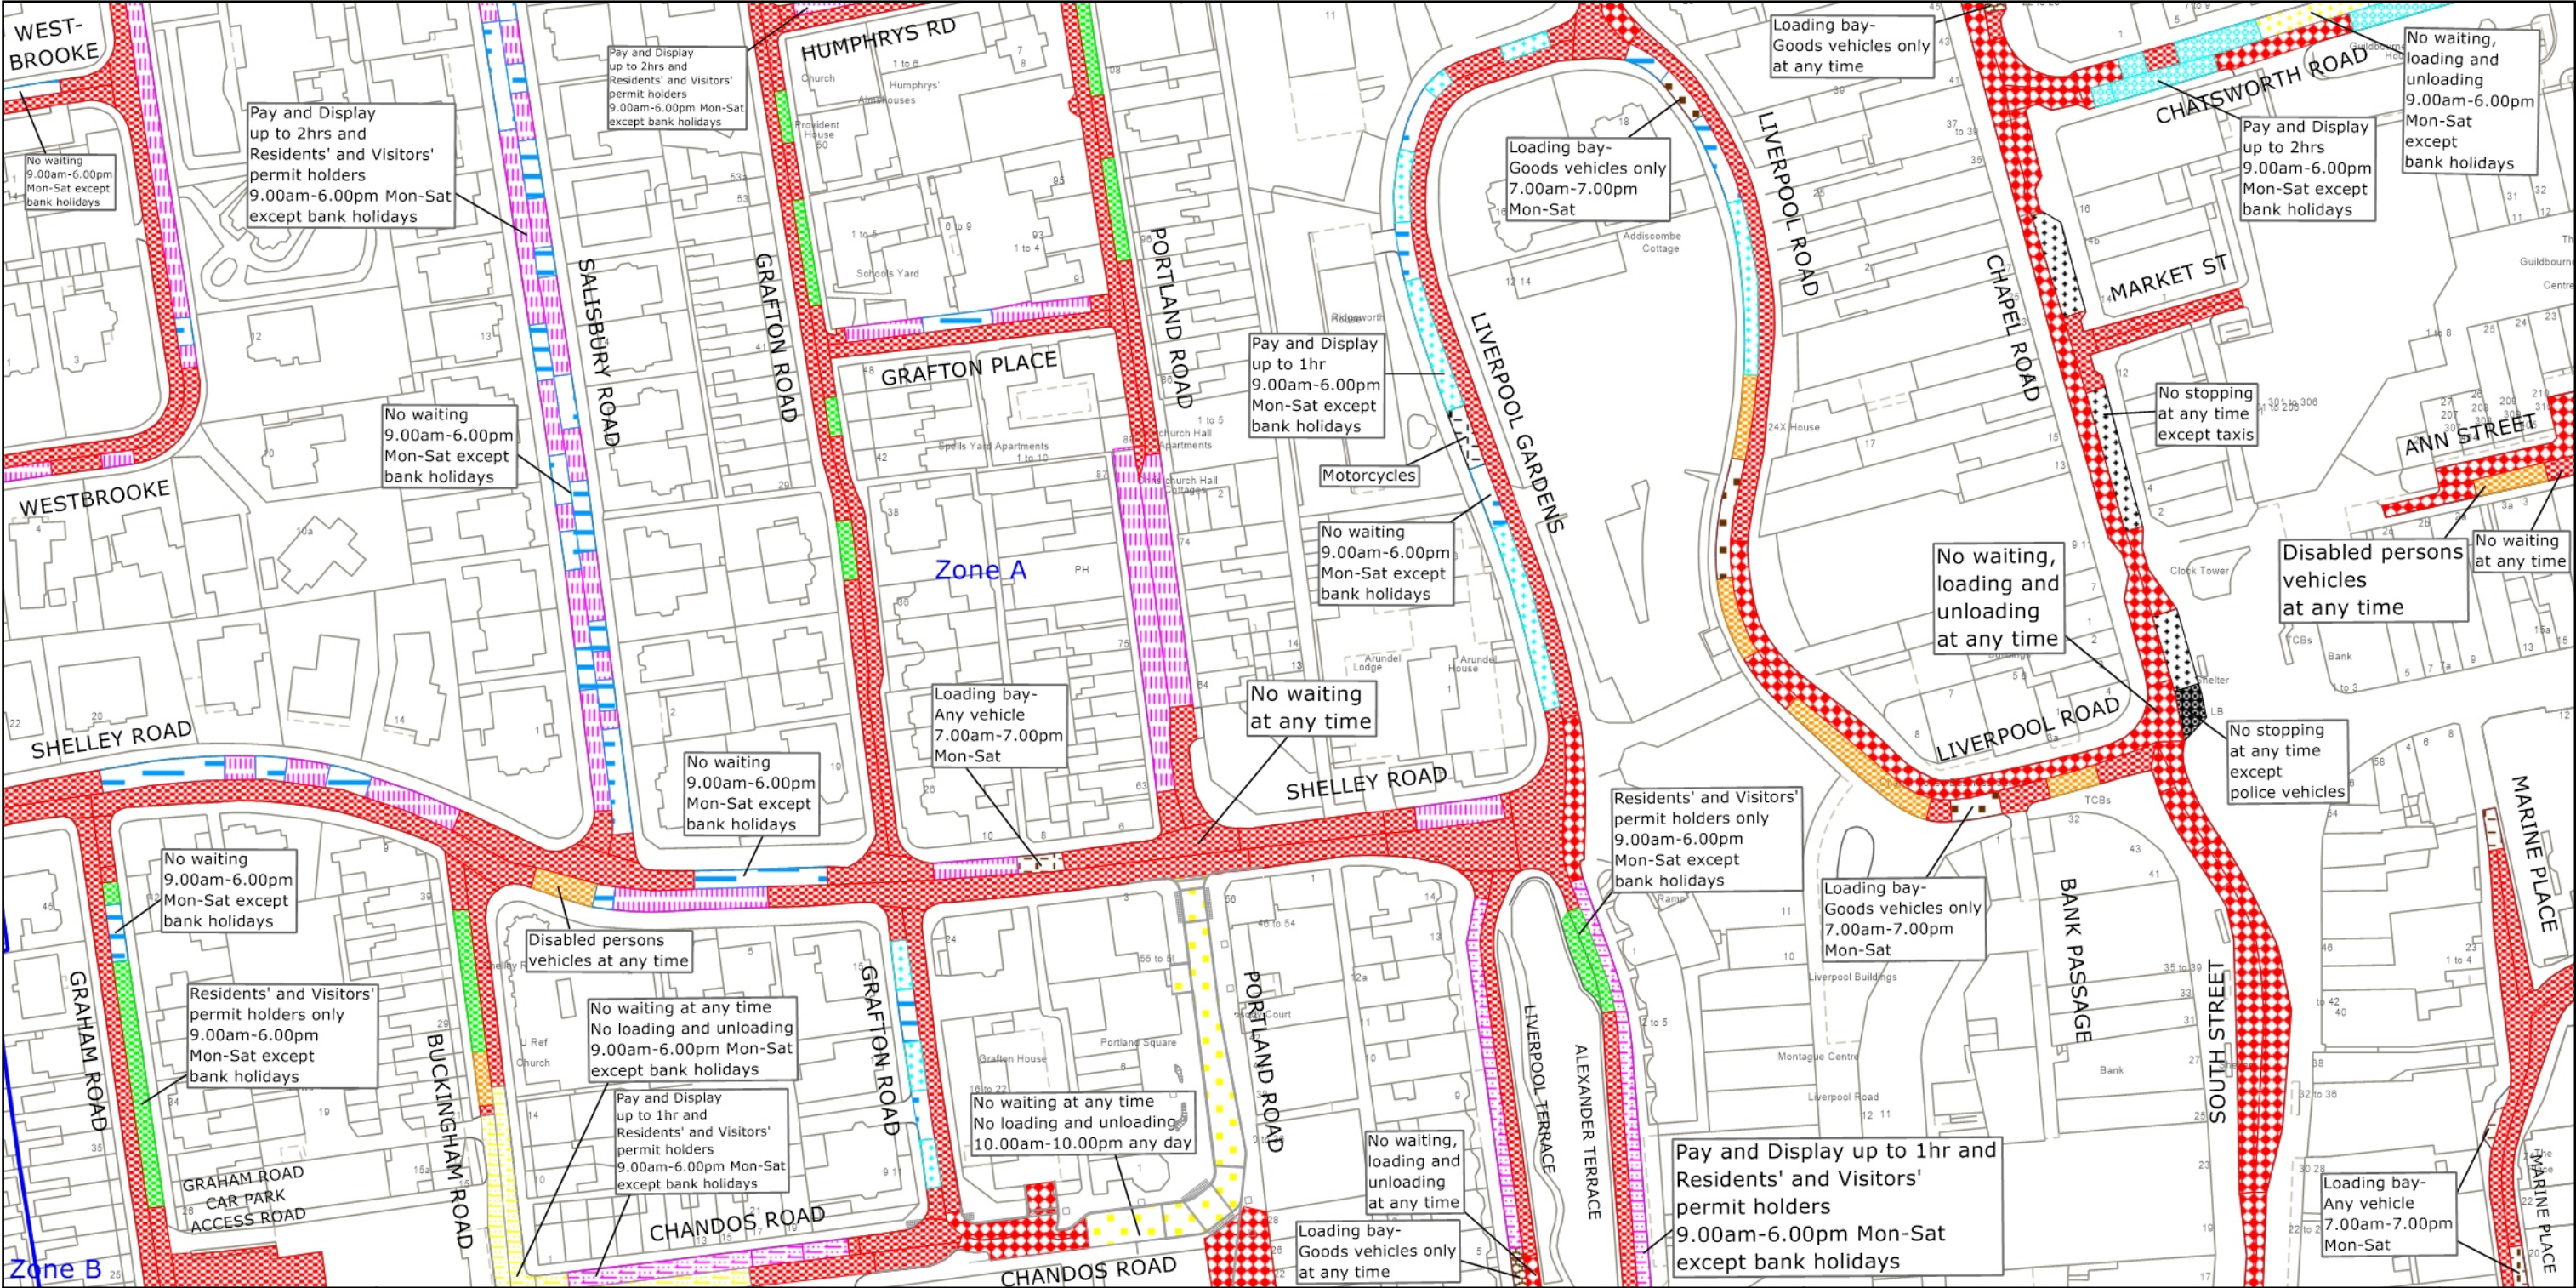

PAGE 2 OF 2: PROPOSED CHANGES TO RESTRICTIONS (CIRCLED)

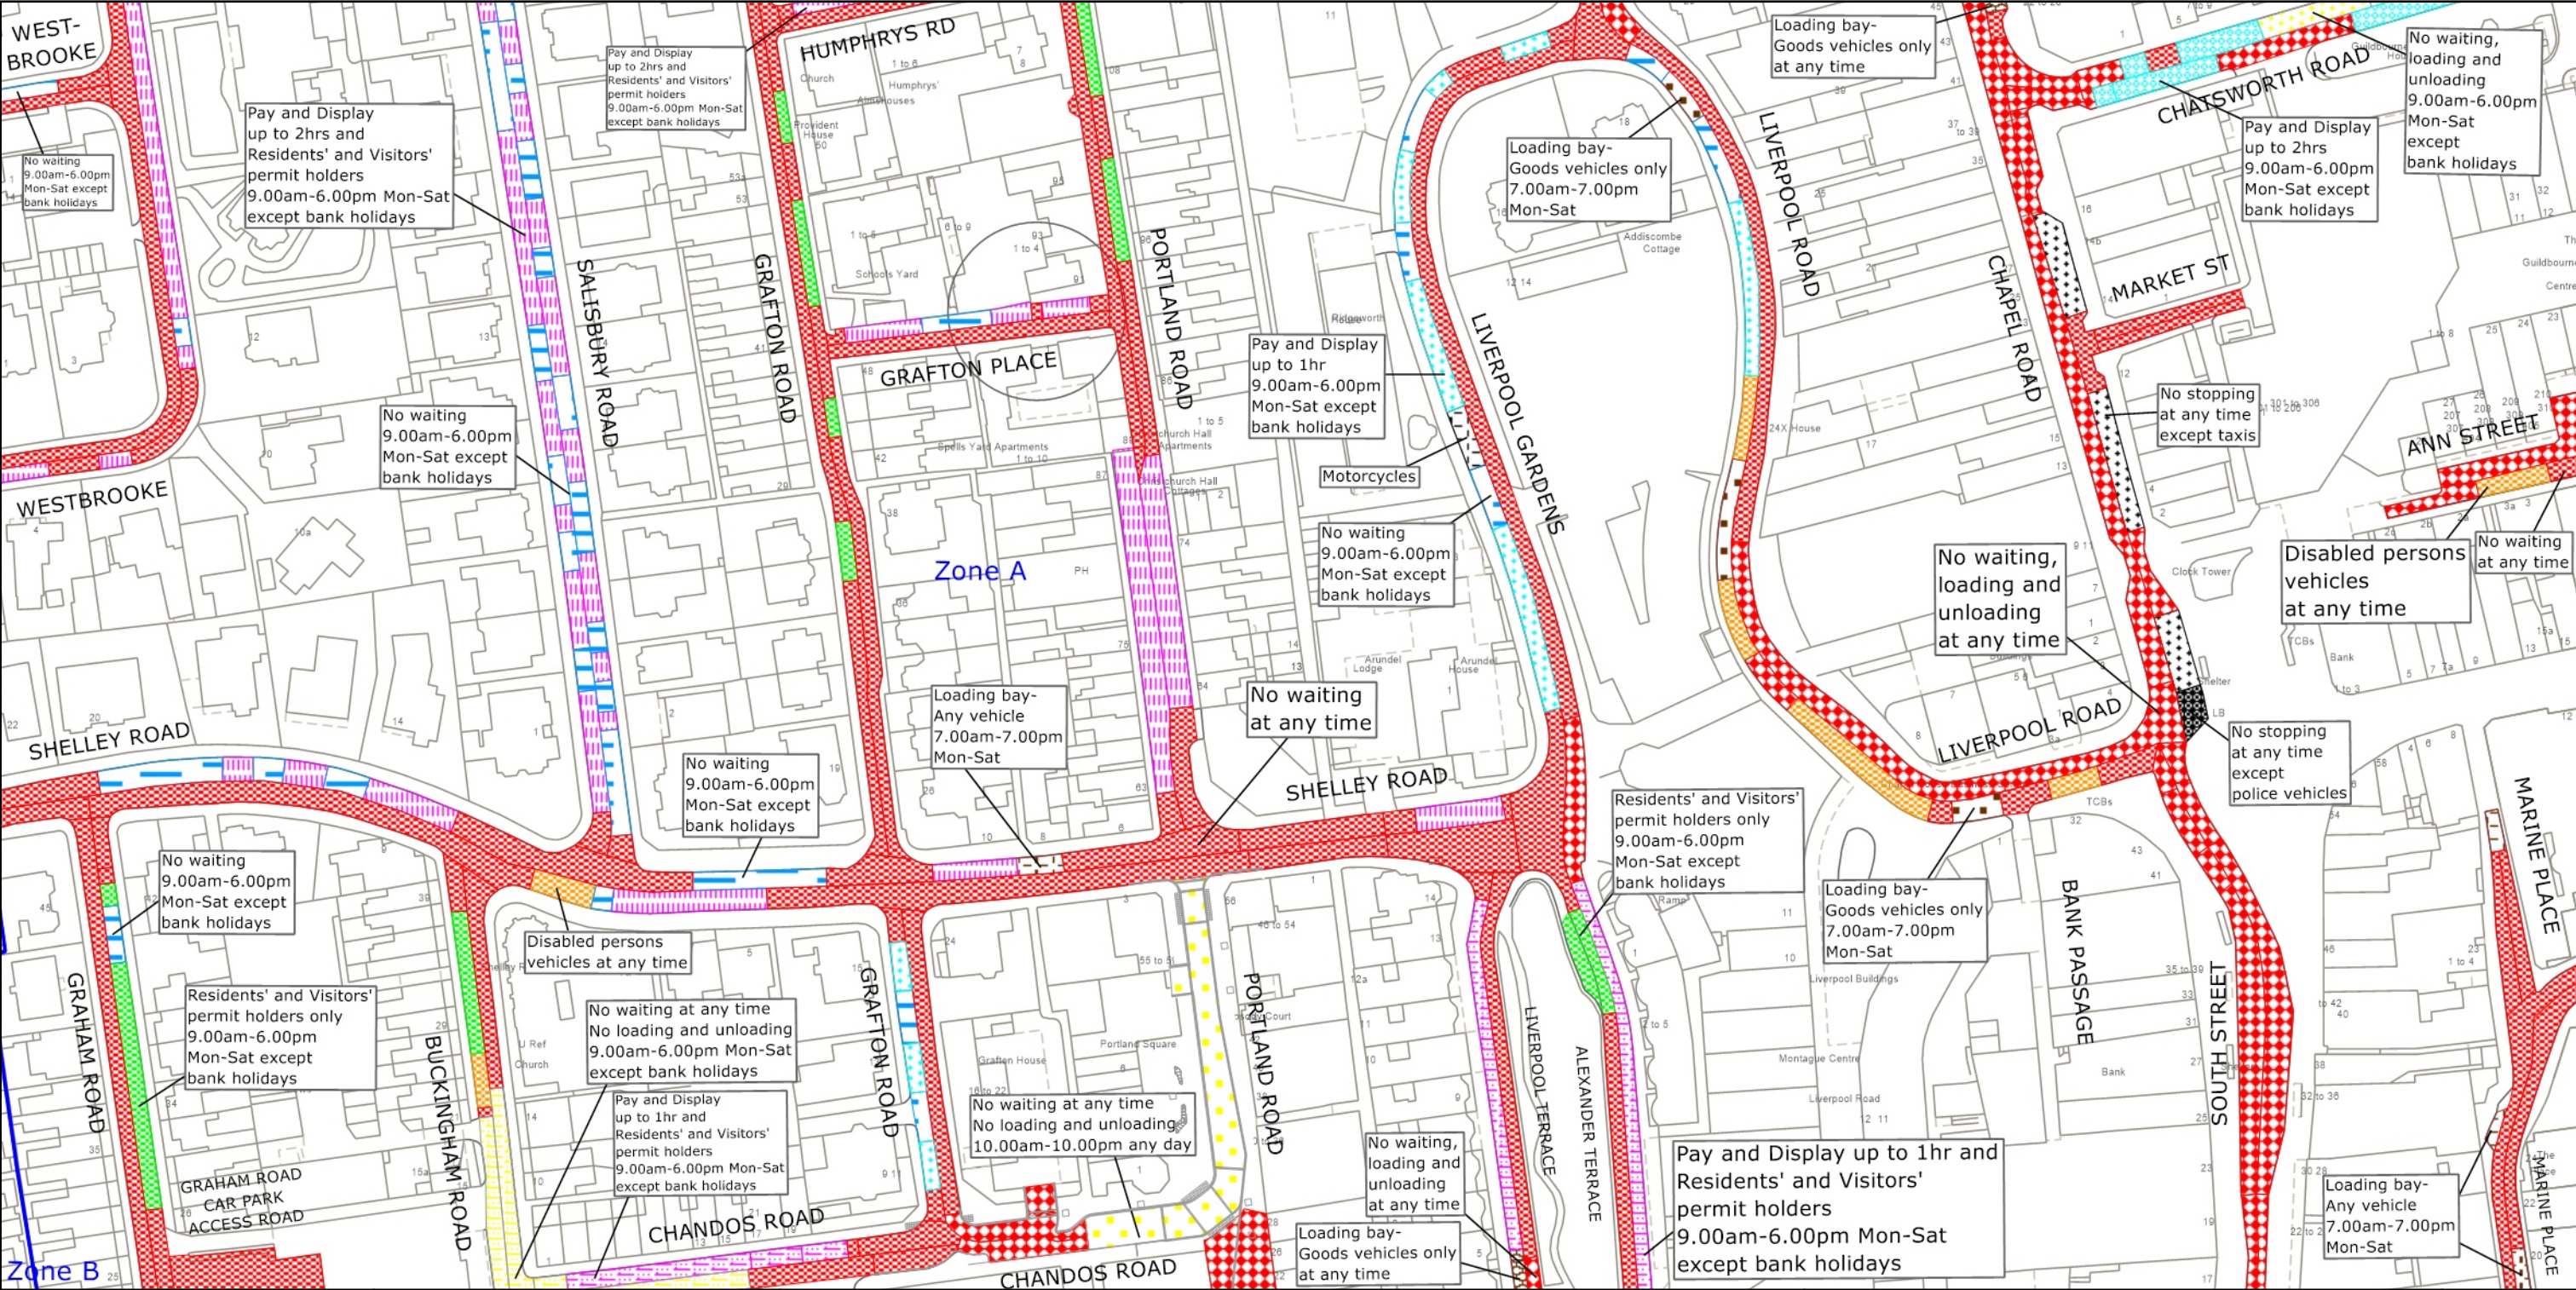

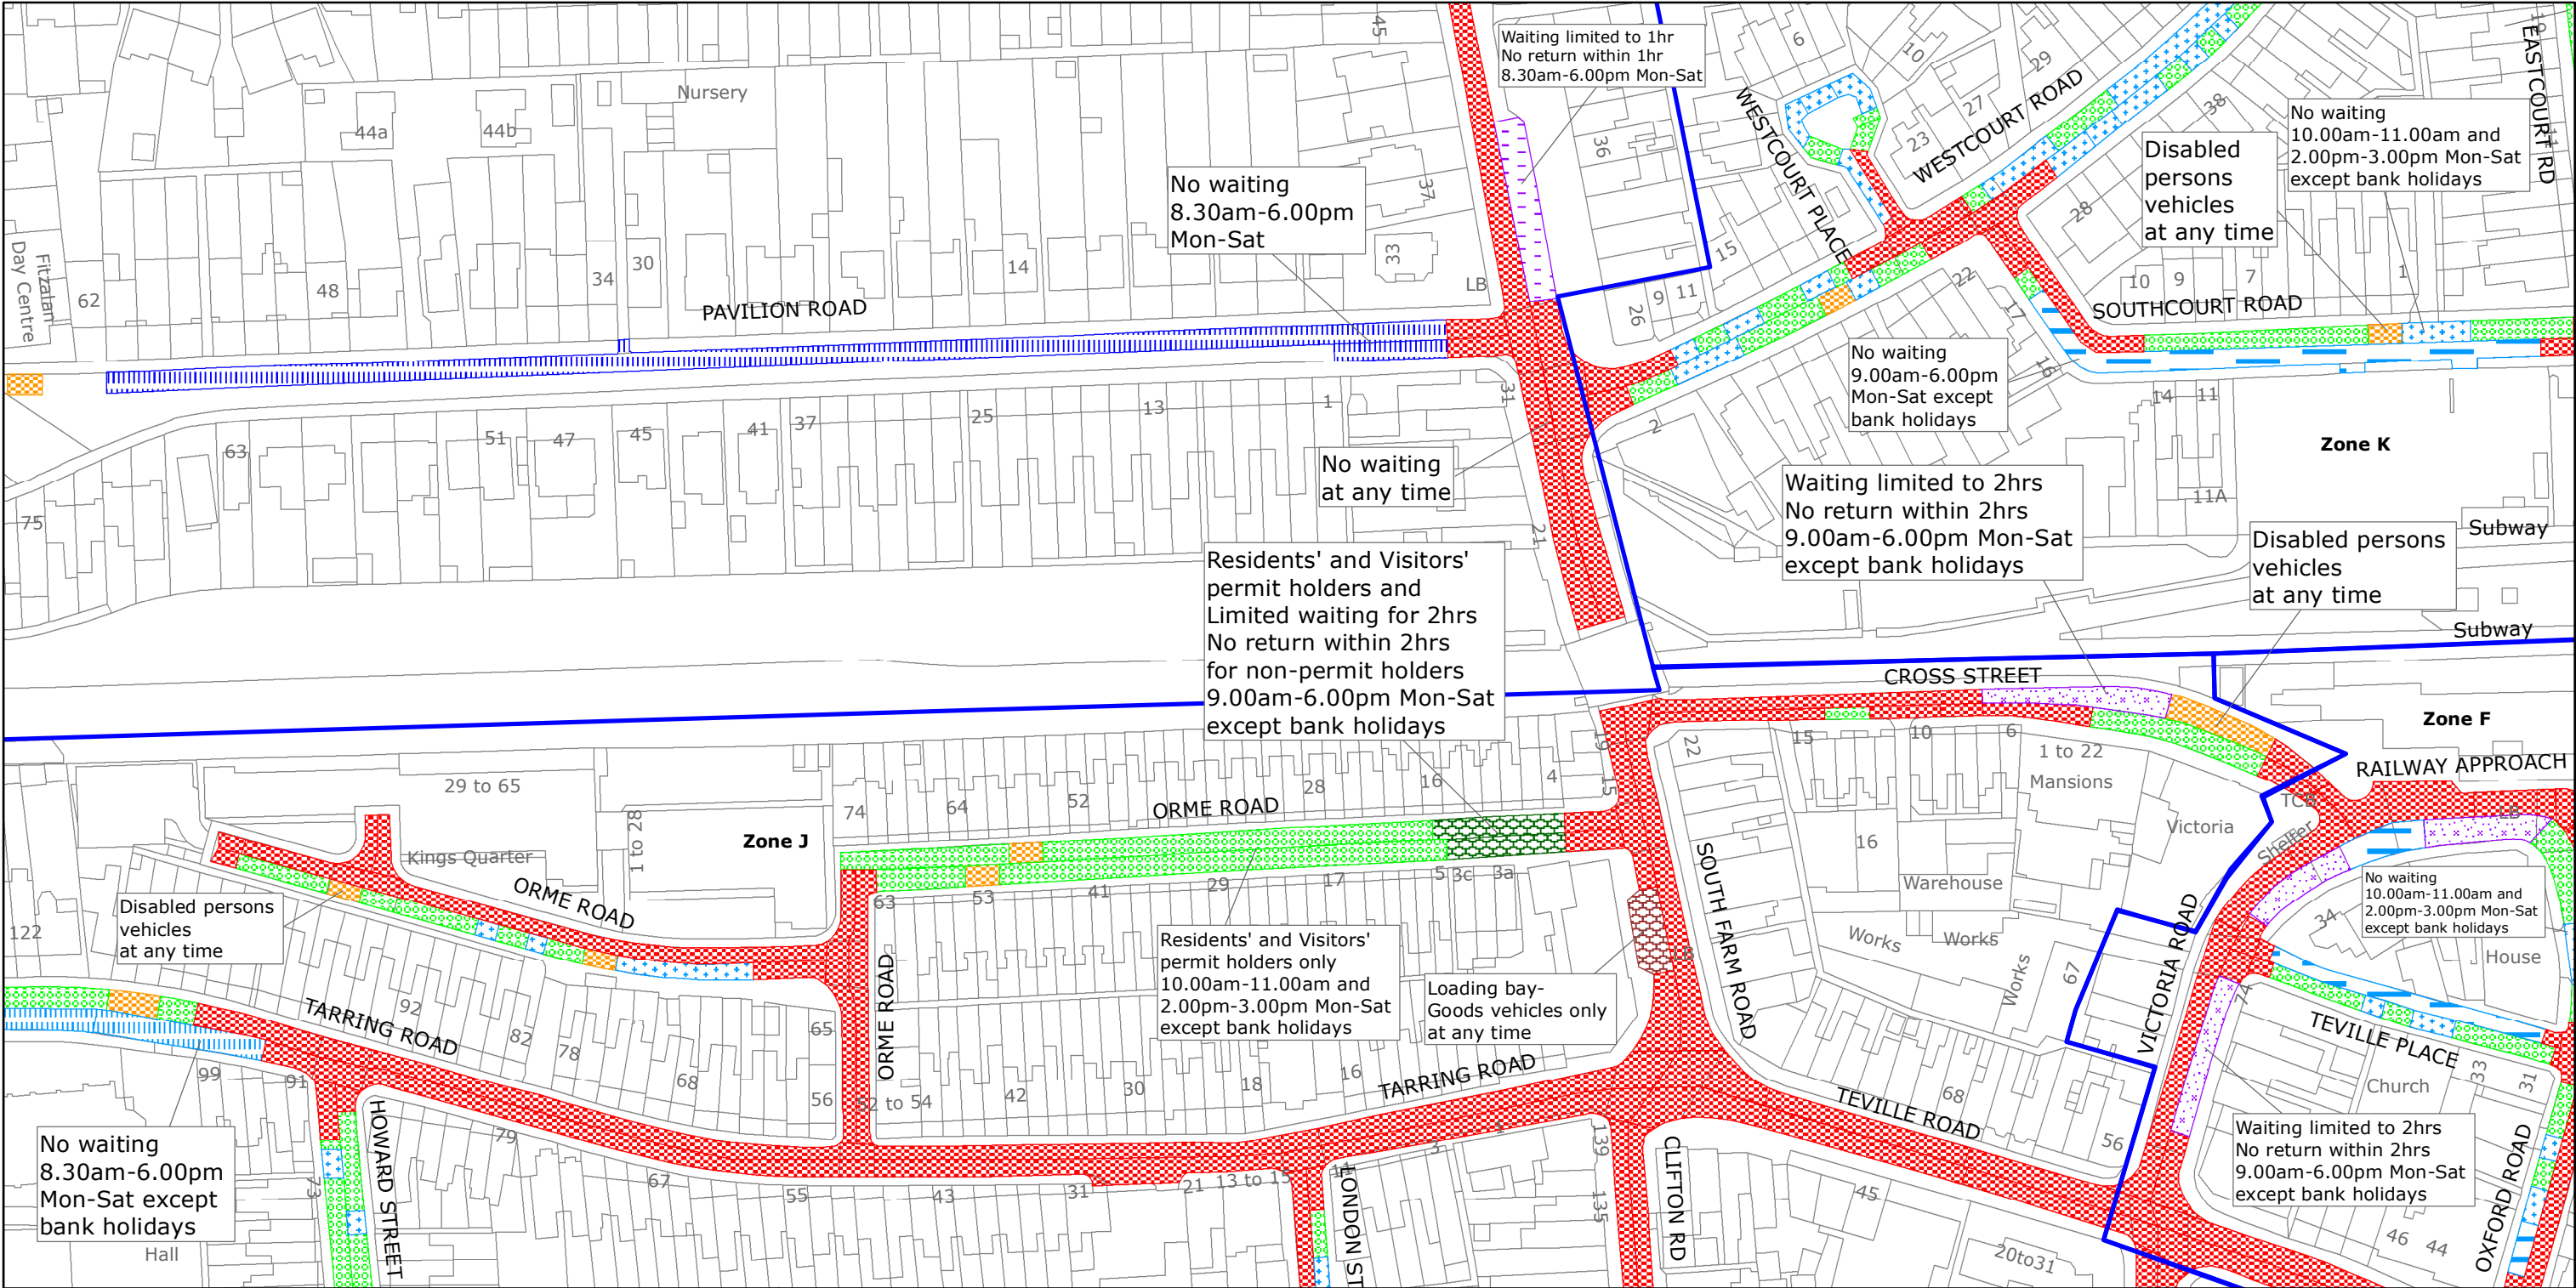

West Sussex County Council
Highways & Transport
The Grange
Tower Street
Chichester
West Sussex
PO19 1RH

WORTHING BOROUGH: CENTRAL AND
GAISFORD WARDS

WAITING RESTRICTIONS

Reproduced from or based upon 2019 Ordnance Survey mapping with permission of the Controller of HMSO (c) Crown Copyright reserved.
Unauthorised reproduction infringes Crown copyright and may lead to prosecution or civil proceedings West Sussex County Council Licence No. 100018485


TILE REF NO:
TQ1403SWN


SHEET ISSUE NO 7
SHEET ACTIVE FROM - 22/07/2019

N


SCALE:
1:1250
at A3 size

PAGE 2 OF 2: PROPOSED CHANGES TO RESTRICTIONS (CIRCLED)

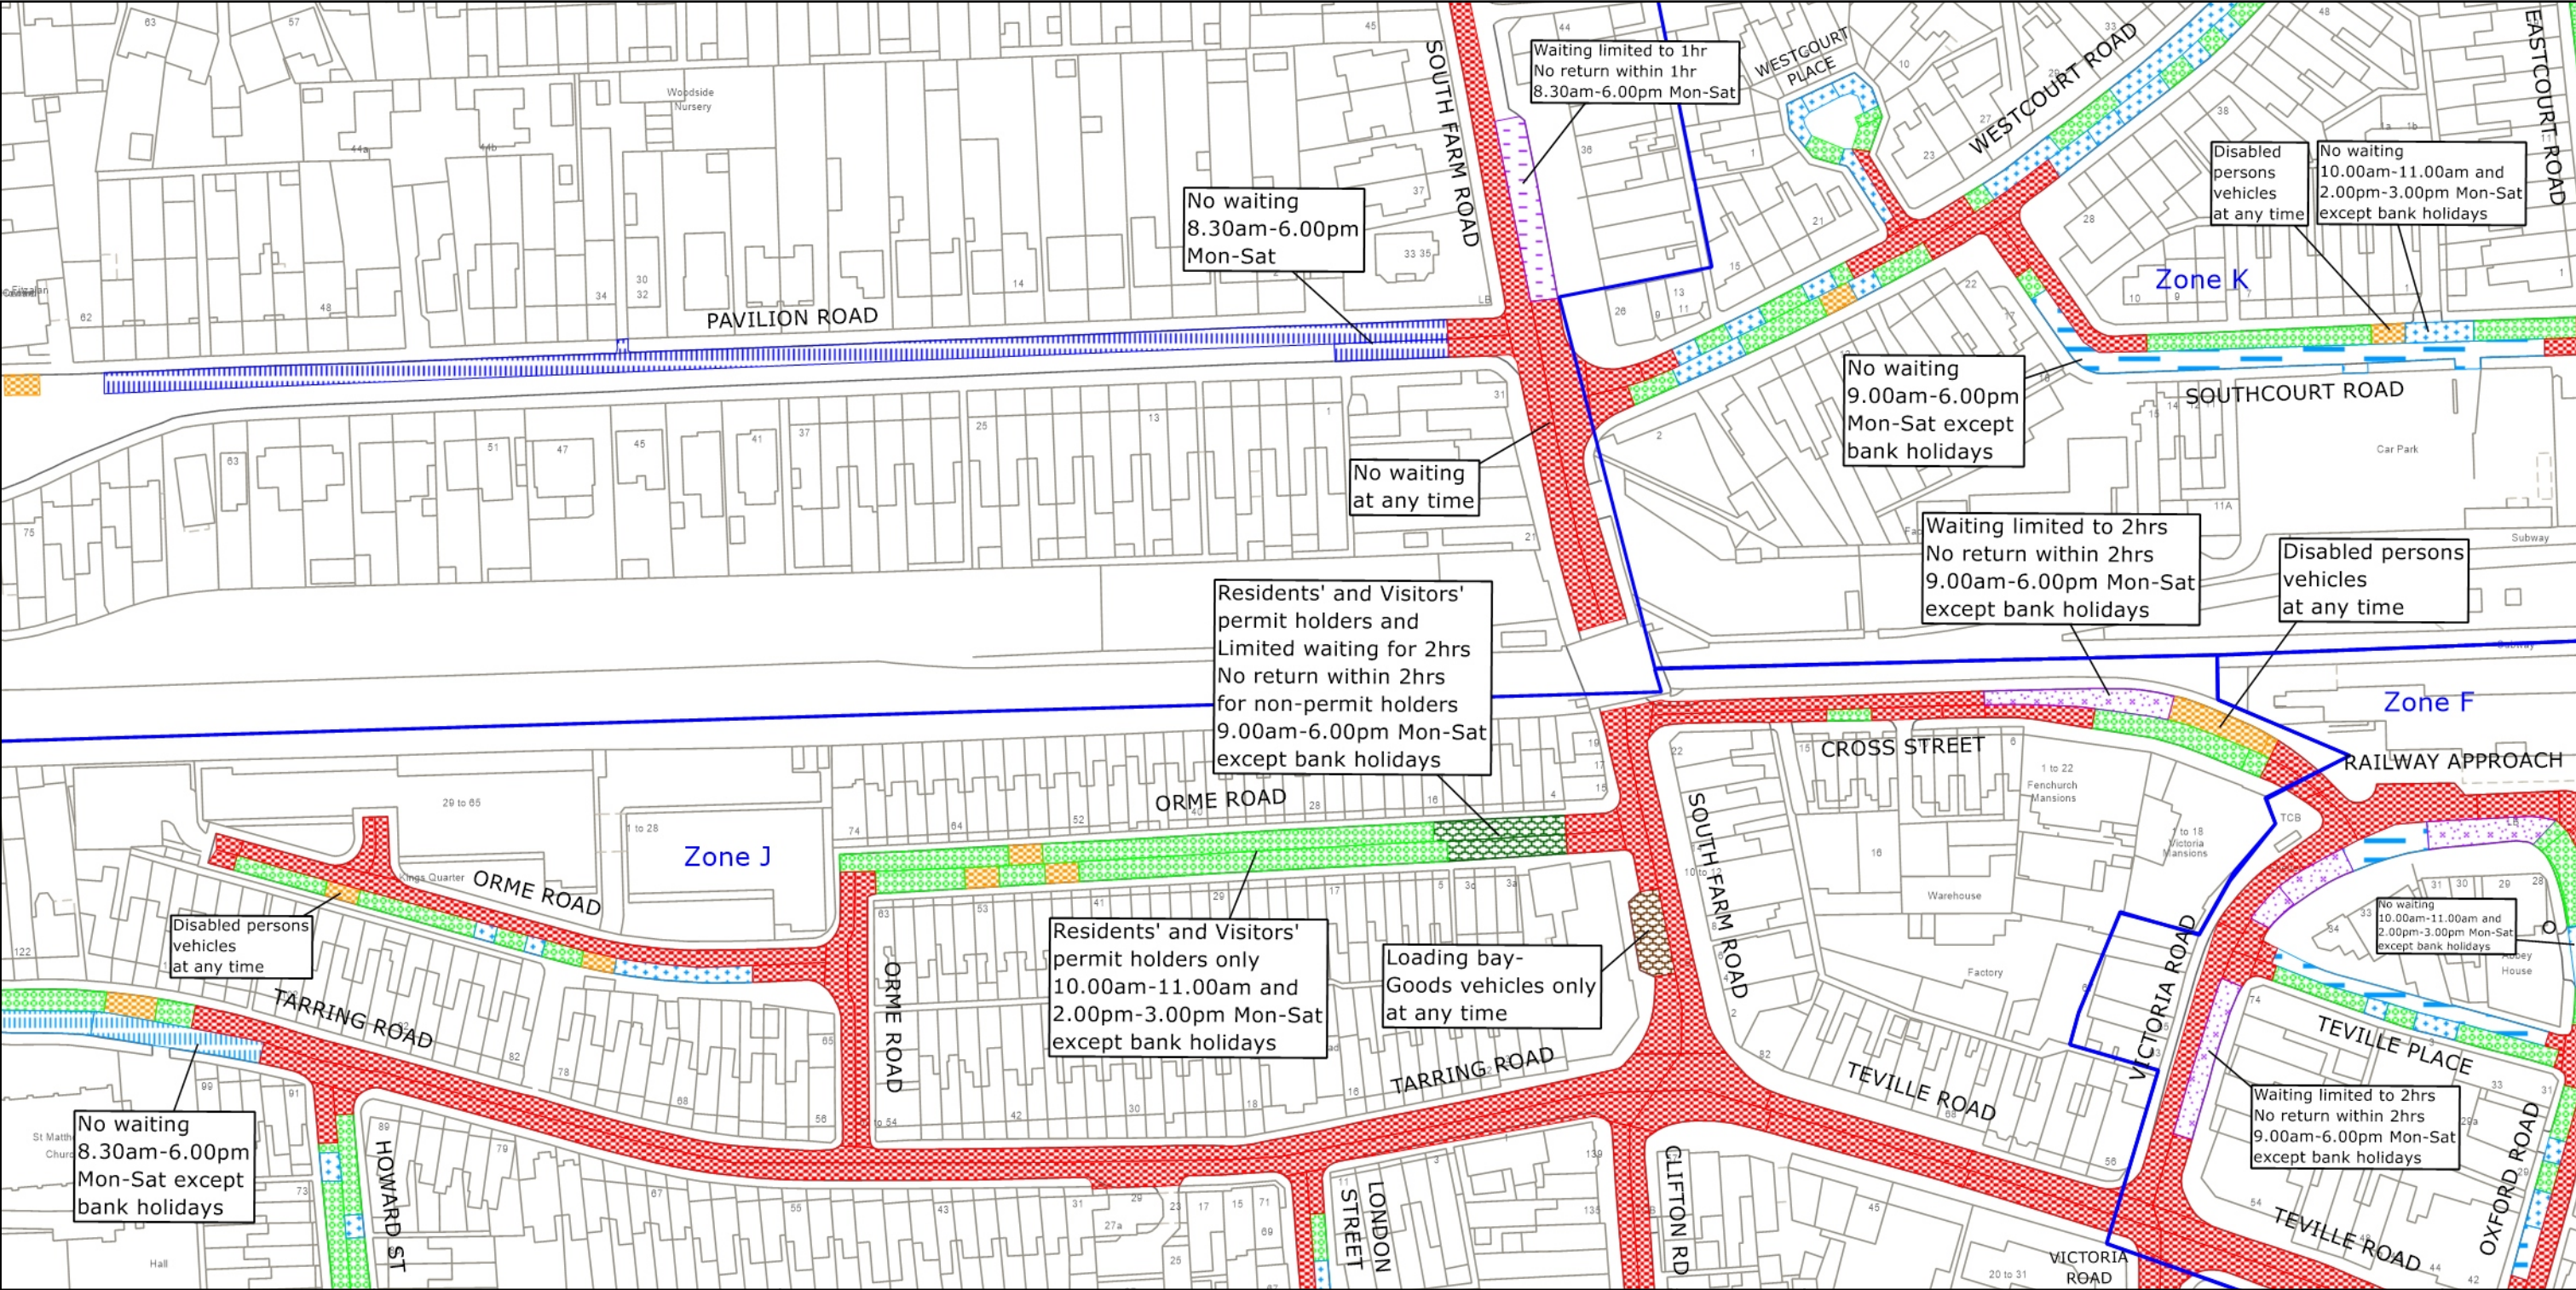



 <p>West Sussex County Council Highways & Transport The Grange Tower Street Chichester West Sussex PO19 1RH</p>	<p>WORTHING BOROUGH: CENTRAL AND GAISFORD WARDS</p> <p>PROPOSED WAITING RESTRICTIONS (15.08.2024)</p> <p><small>© Crown copyright and database rights 2024 OS AC0000849983. You are permitted to use this data solely to enable you to respond to, or interact with, the organisation that provided you with the data. You are not permitted to copy, sub-license, distribute or sell any of this data to third parties in any form.</small></p>	<p>TILE REF NO: TQ1403SWN</p> <p>SHEET ISSUE NO 8a_FIX</p> <p>SHEET ACTIVE FROM - DD.MM.YYYY</p>	<p>N</p> <p>SCALE: 1:1250 at A3 size</p>
---	--	---	--

PAGE 1 OF 2: EXISTING RESTRICTIONS ONLY

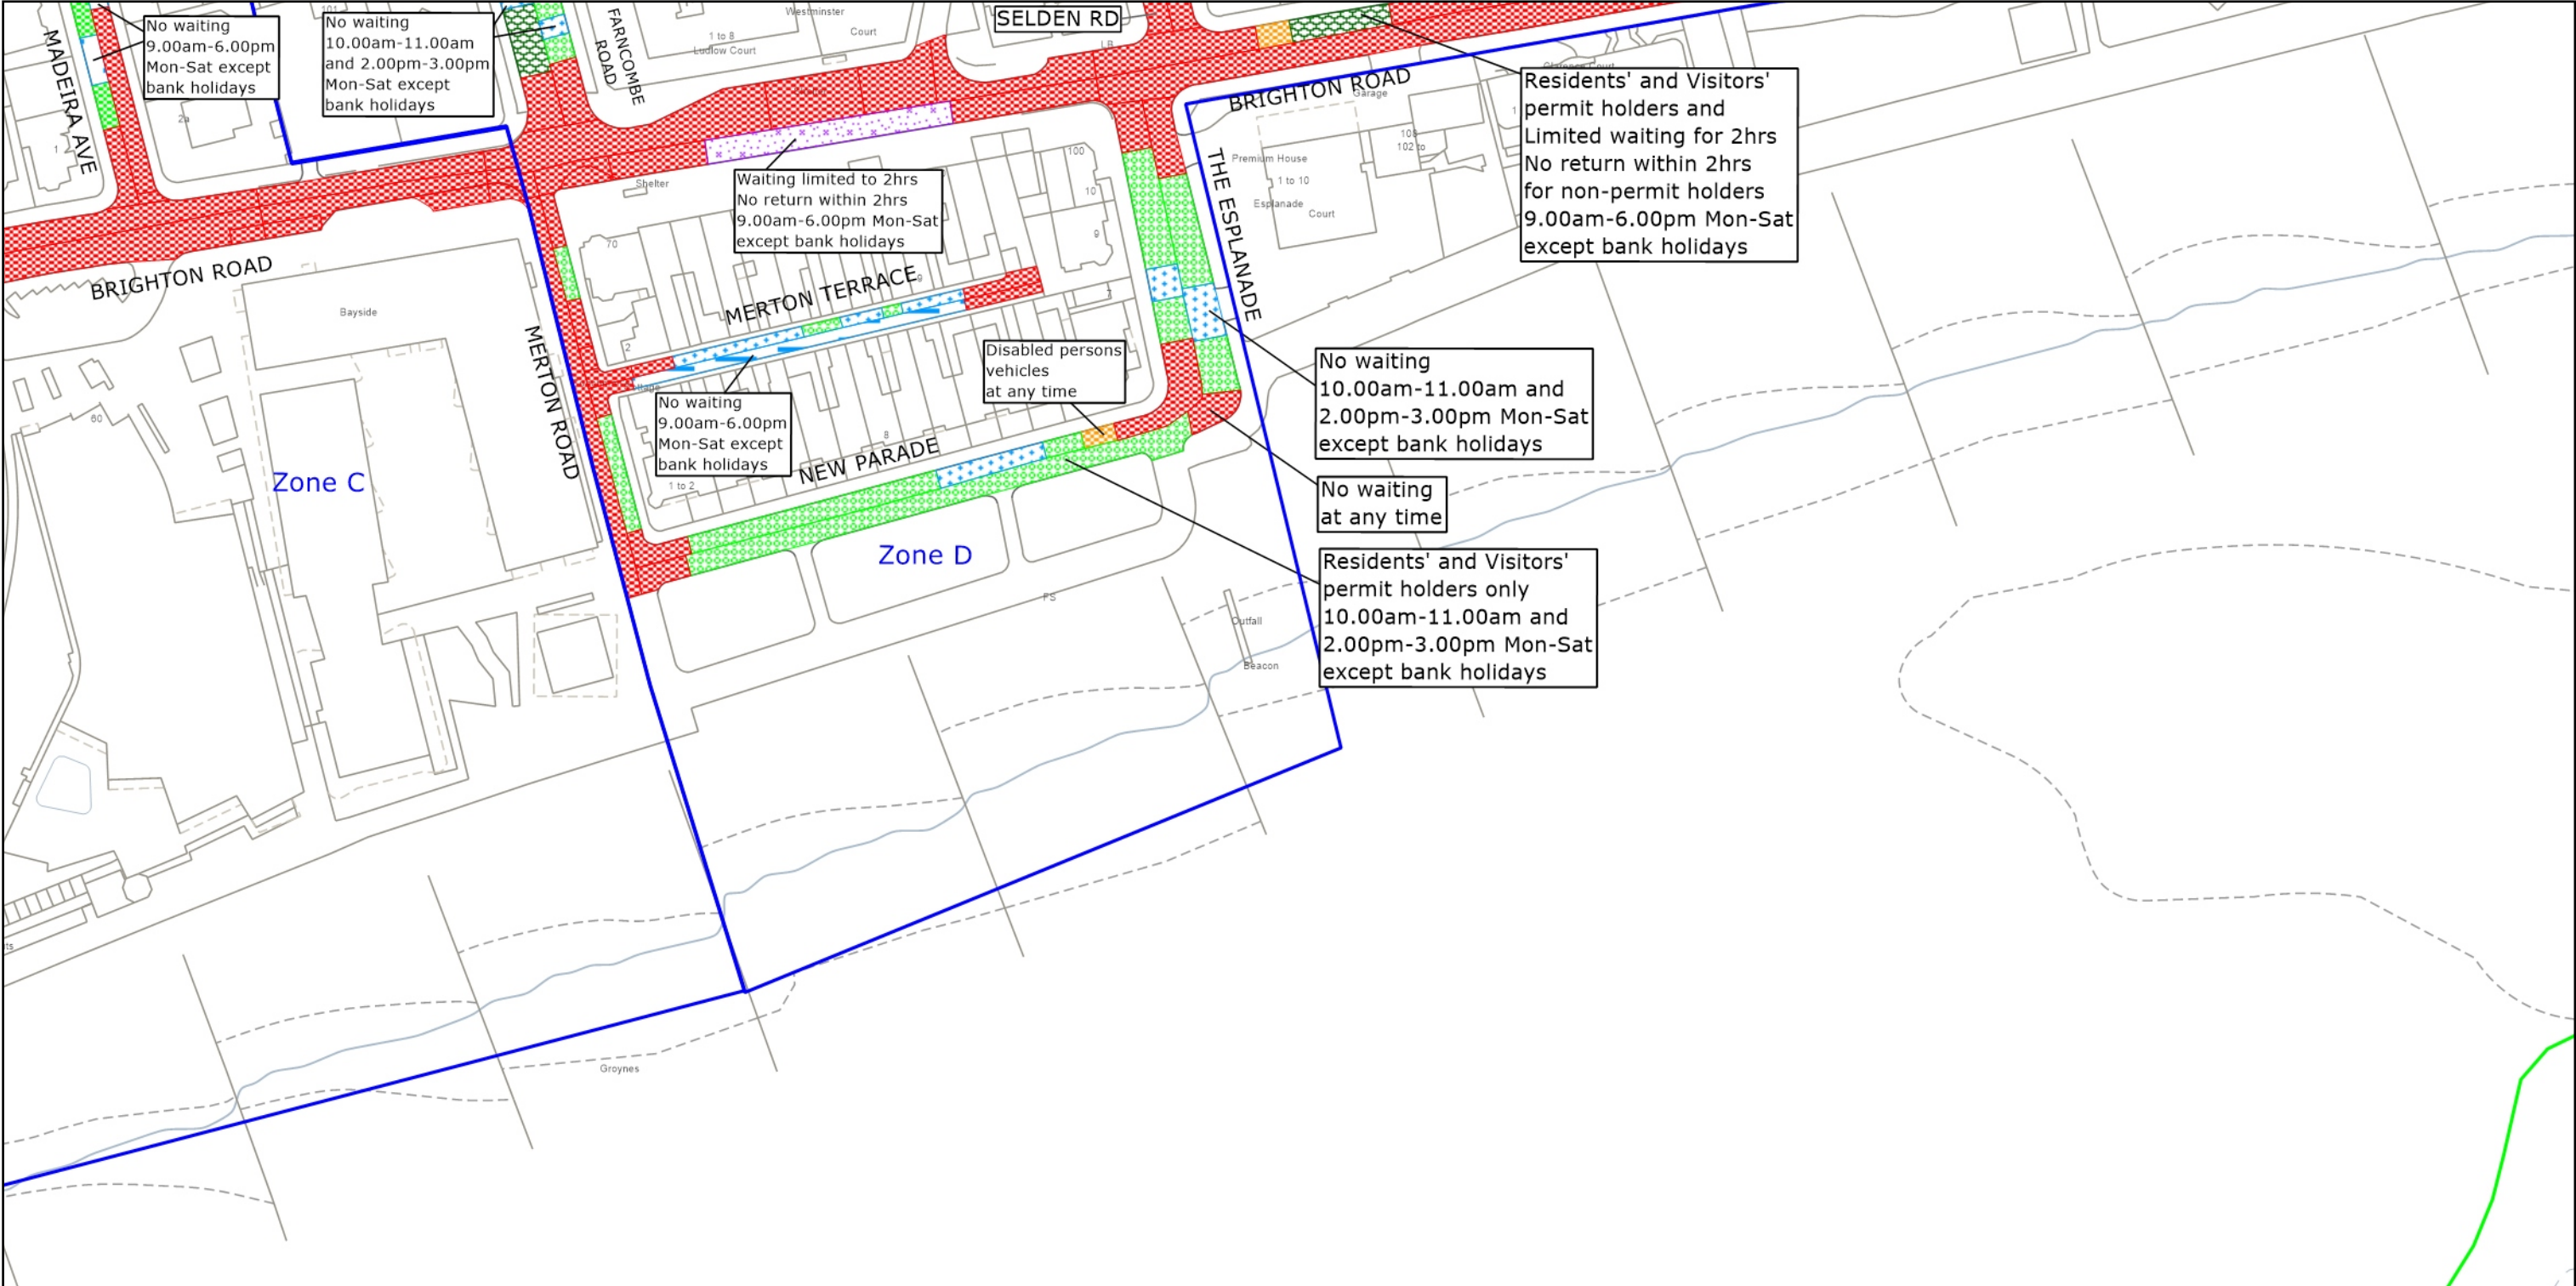

PAGE 2 OF 2: PROPOSED CHANGES TO RESTRICTIONS (CIRCLED)

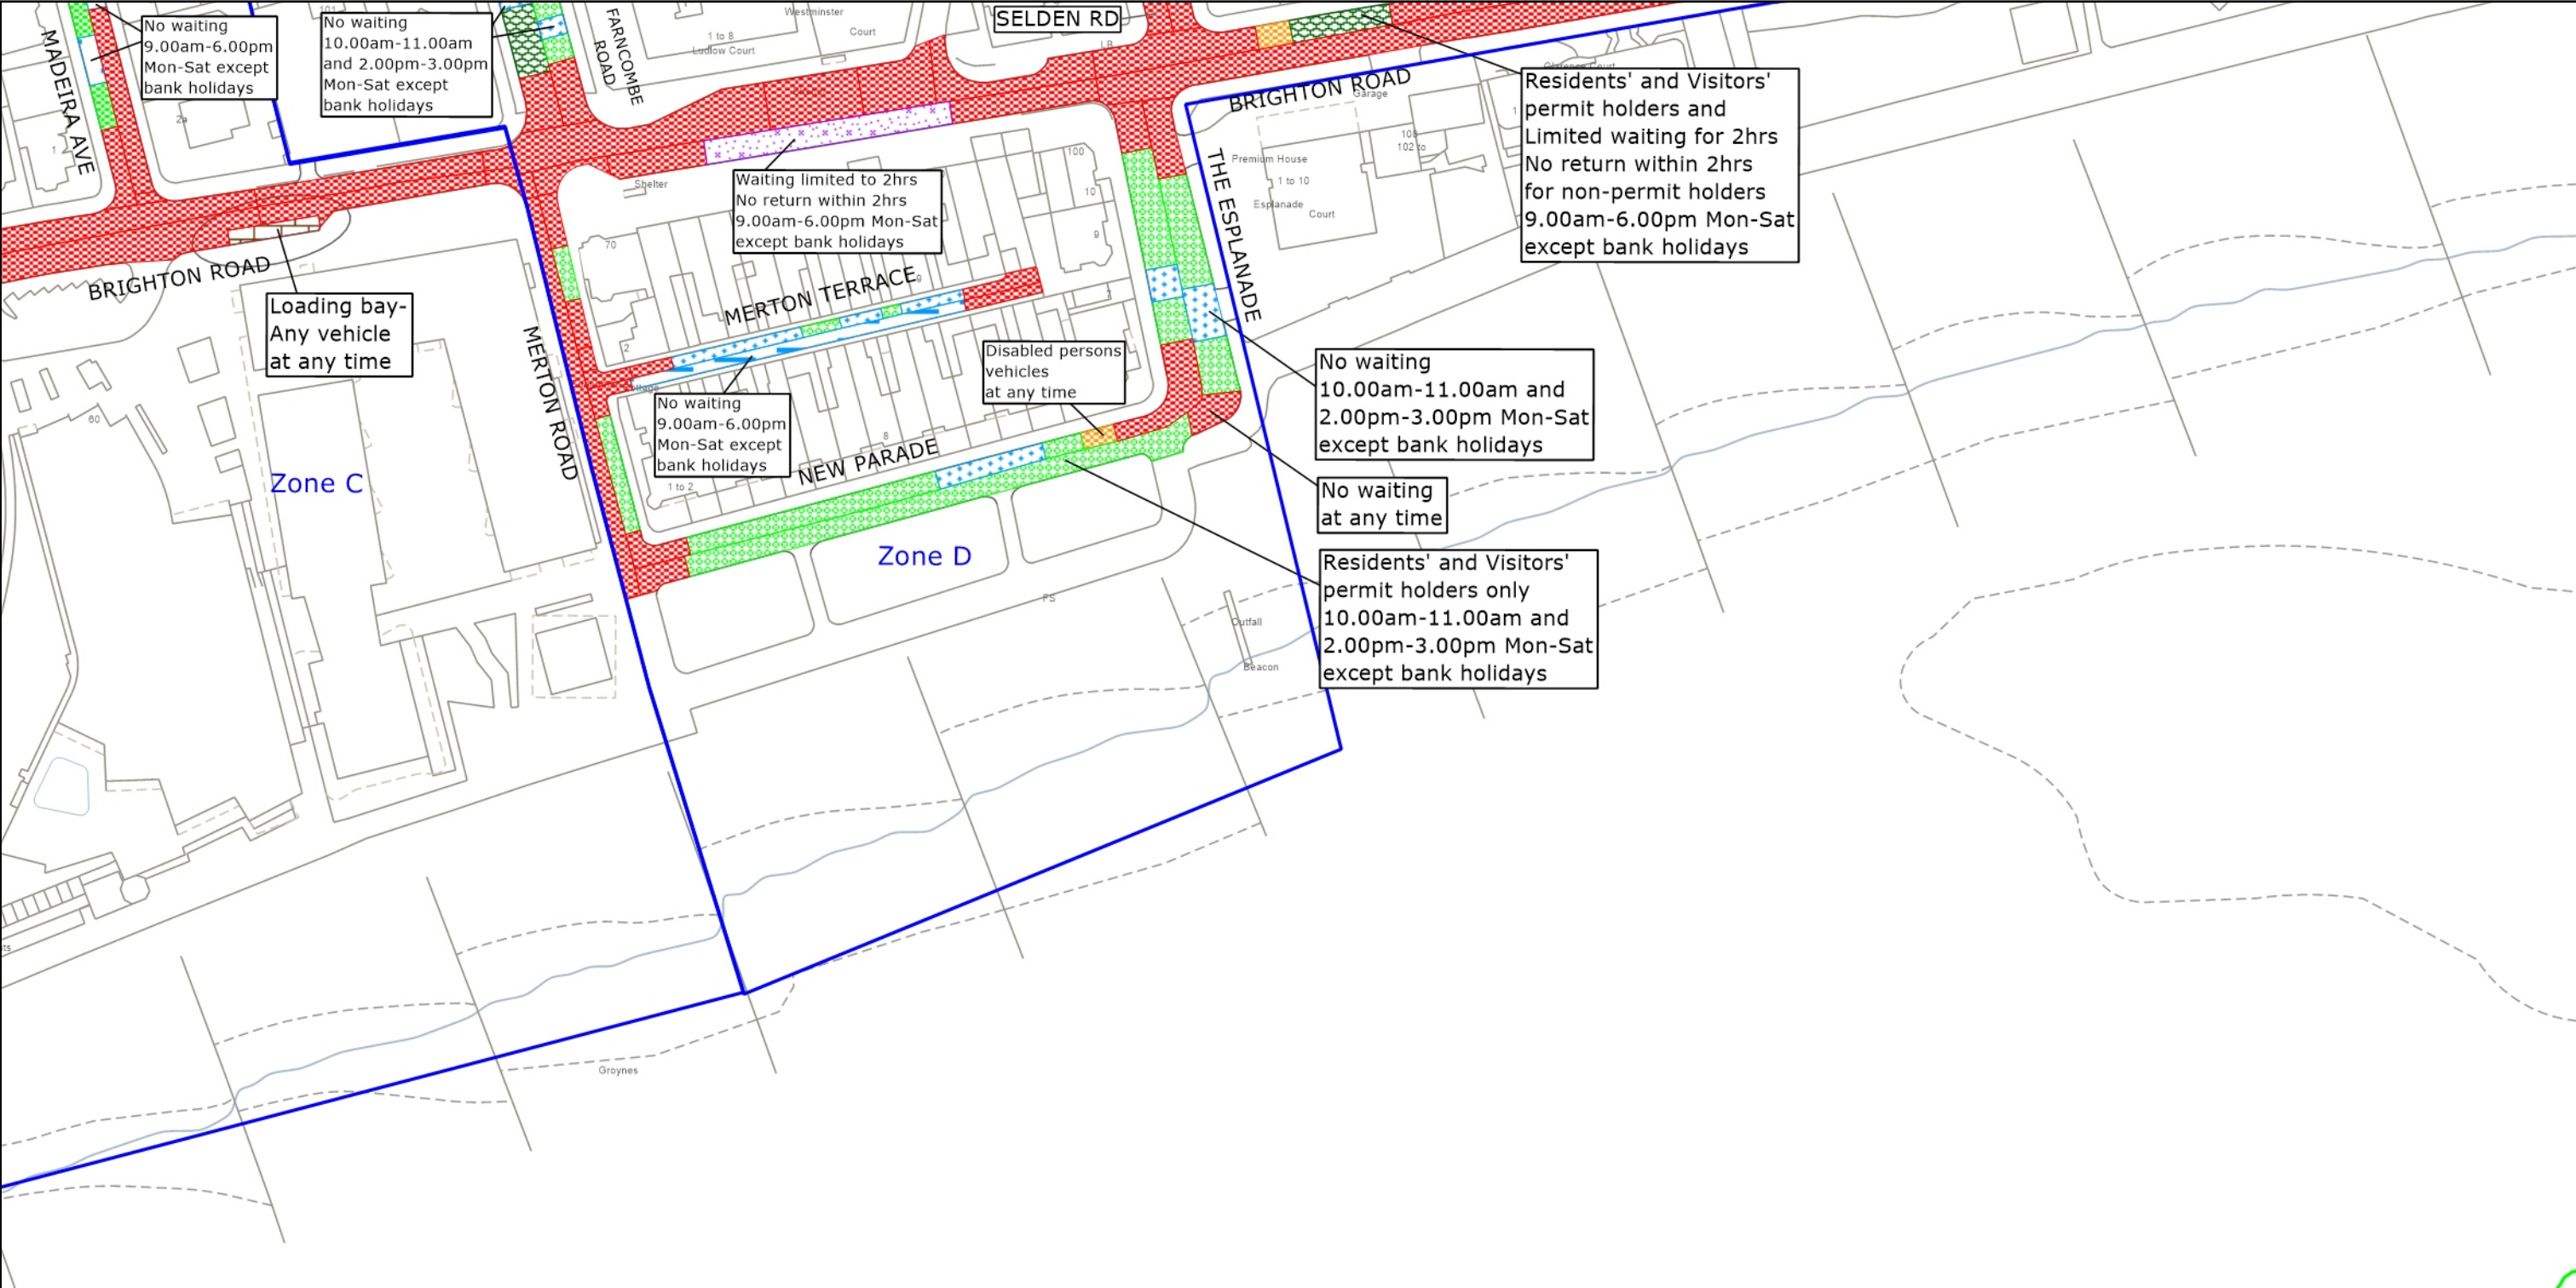

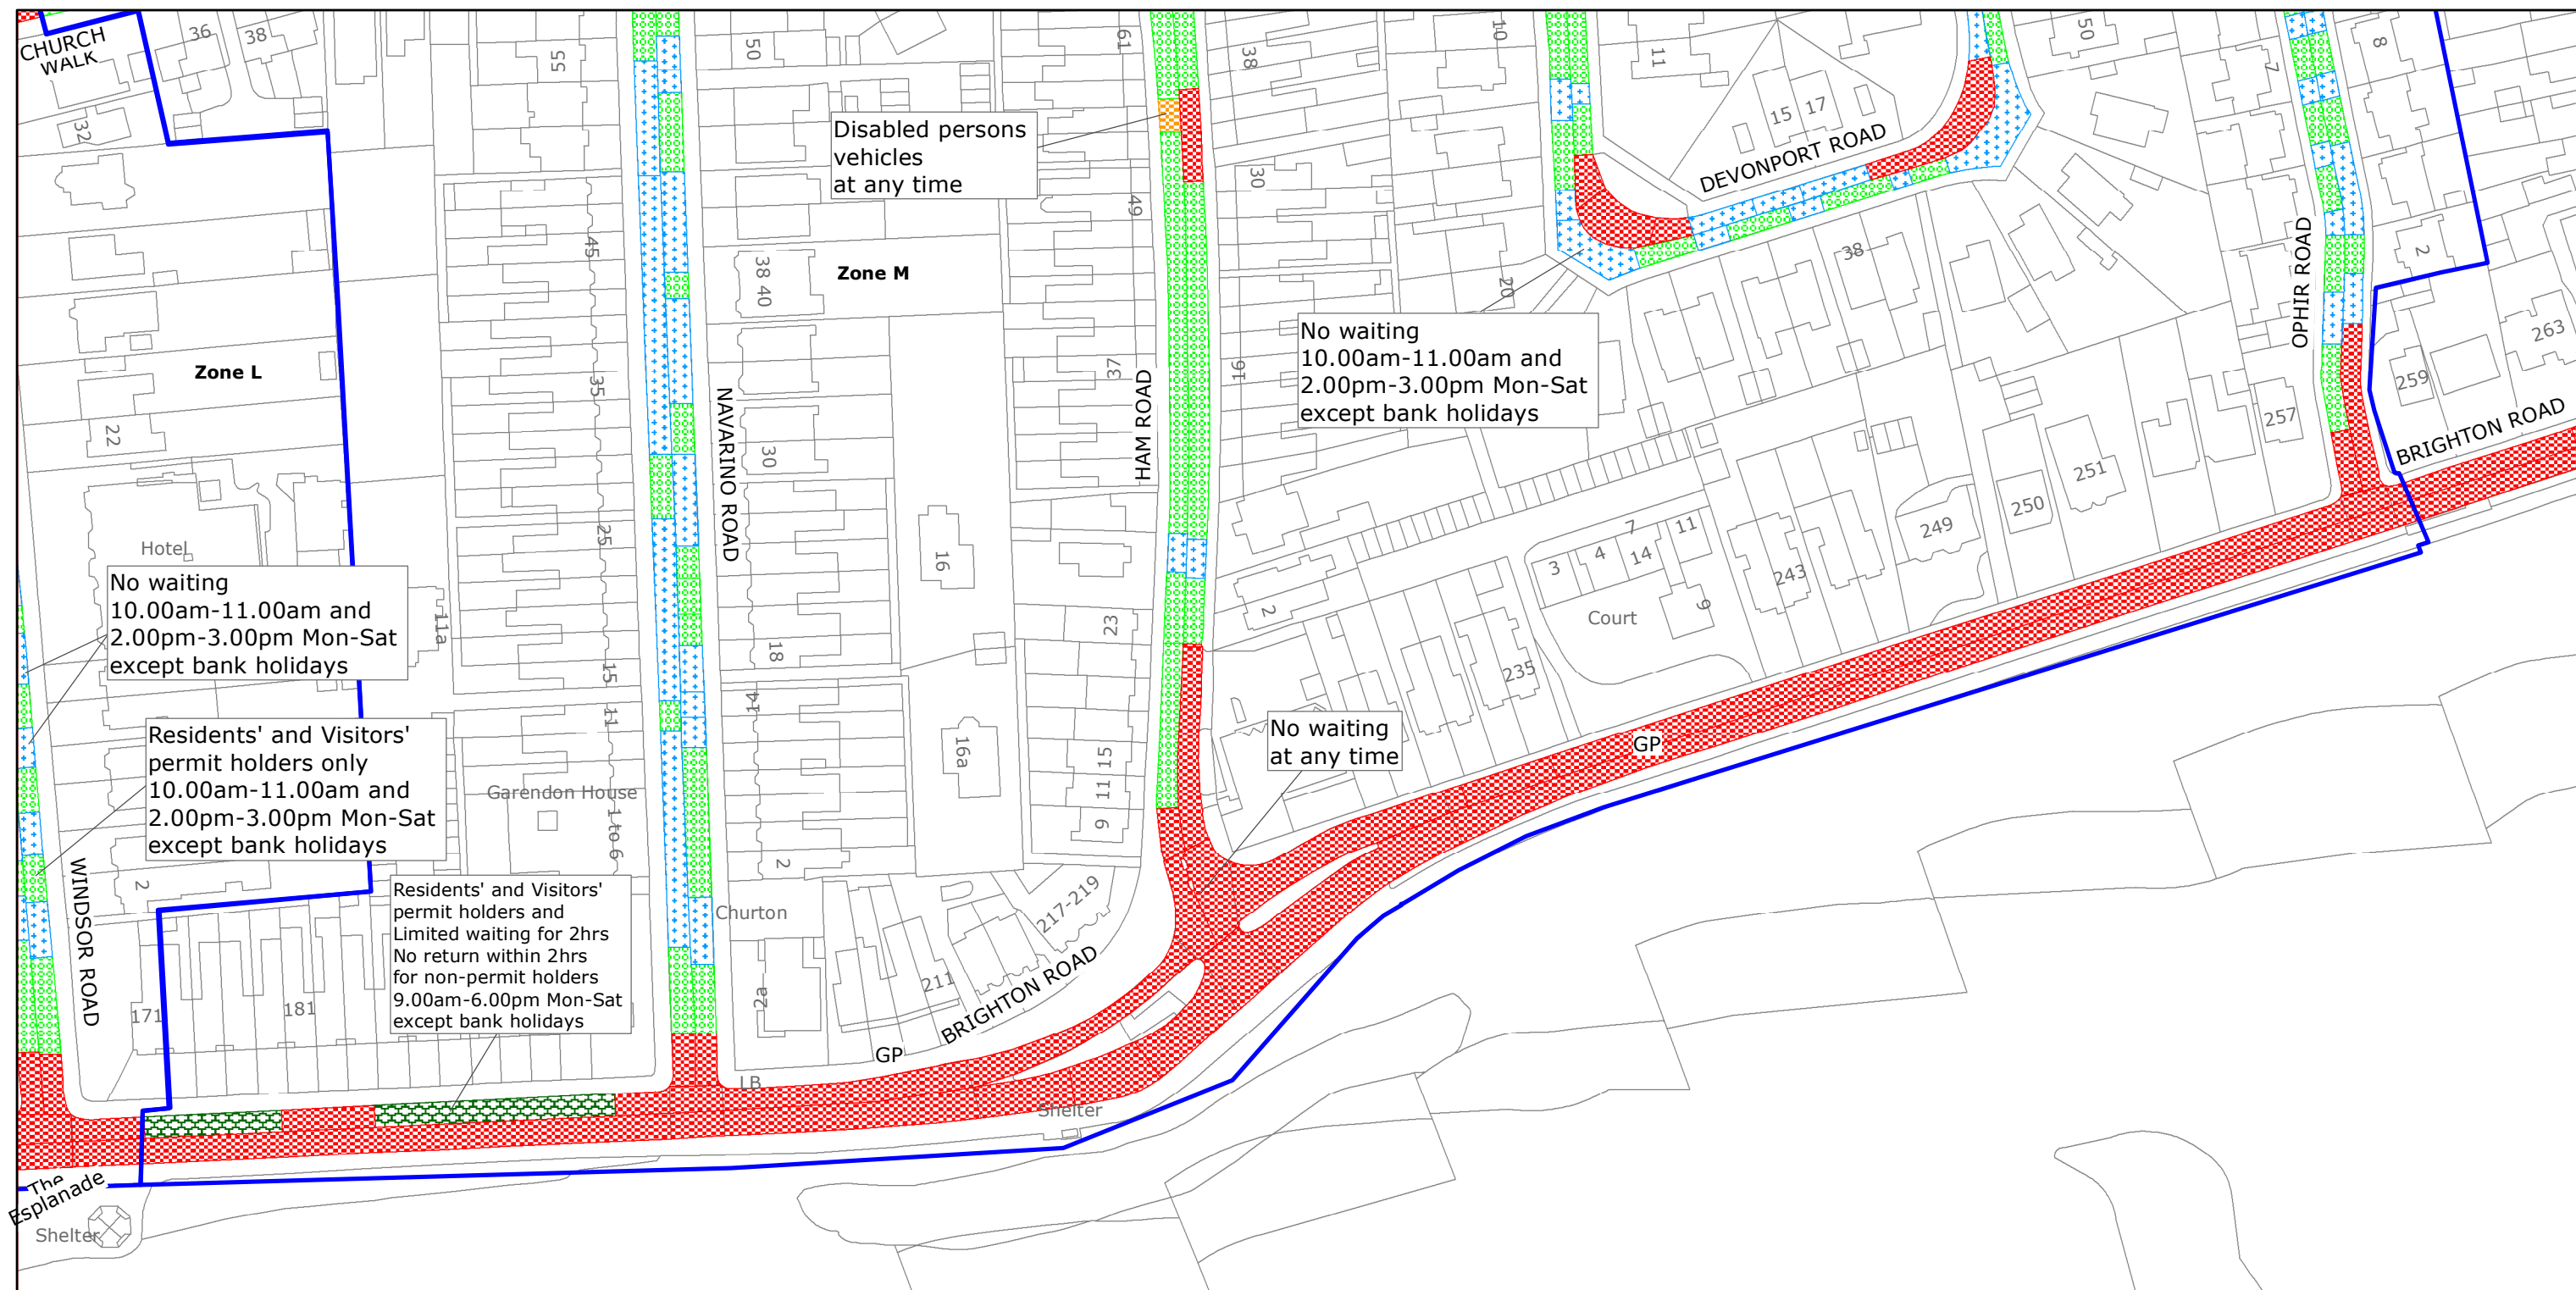

West Sussex County Council
Highways & Transport
The Grange
Tower Street
Chichester
West Sussex
PO19 1RH

WORTHING BOROUGH: SELDEN WARD
WAITING RESTRICTIONS

Reproduced from or based upon 2017 Ordnance Survey mapping with permission of the Controller of HMSO (c) Crown Copyright reserved.
Unauthorised reproduction infringes Crown copyright and may lead to prosecution or civil proceedings West Sussex County Council Licence No. 100018485

TILE REF NO:
TQ1602NWN

SHEET ISS NO 5
SHEET ACTIVE FROM - 15/09/2017



SCALE:
1:1250
at A3 size

PAGE 2 OF 2: PROPOSED CHANGES TO RESTRICTIONS (CIRCLED)

